CUSTOMER: Durham County Human Services



"You Imagine It. We Build It."

Manufacturing signs nationwide since 1979

www.signageindustries.com P.O. BOX 4879 ARCHDALE, NC 27263

LOCATION: Durham, NC

SIGN TYPE: SCALE: 1.0 1/8" = 1'-0"

DRAWN BY:

REFERENCE #: 13393-M

REVISION: DATE:


DATE: DRAWING #: 08-29-19 19465-M

○APPROVED AS DRAWN ○APPROVED AS NOTED ○ REJECTED-REVISE AND RESUBMIT

SIGNATURE:

DATE: _____

© 2019 COPYRIGHT MATERIAL REPRODUCTION OF THE ARTWORK OR DESIGNS AS SHOWN ON THIS DOCUMENT WITHOUT THE EXPRESS WRITTEN PERMISSION OF SIGNAGE INDUSTRIES CORP, IS A DIRECT INFRACTION OF THE UNITED STATES COPYRIGHT LAW

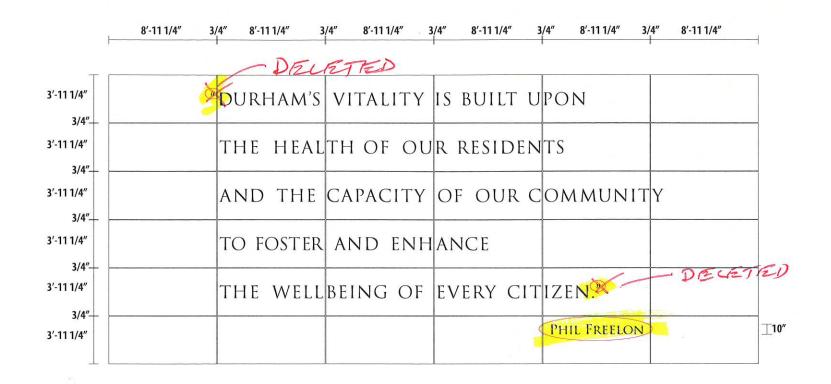

SPECIFICATIONS			COLORS	NOTES
Quantity: 1 Size: 10"	Letter Height: 10" Logo Height: N/A	Installation Method: FLUSH	Letter Color: MATTHEWS 28448 Return Color: MATTHEWS 28448	1/4" ALUMINUM QUOTATIONS AND (PHIL FREELON) TO BE ADDED TO EXISTING LETTERS AS SHOWN.
Square Feet:	Letter Style: TRAJAN PRO		Logo Color: N/A	LETTERS AS SHOWN.
Cut Style: PRECISION	Digital Print: NO			
Material: ALUMINUM	Grain Direction: N/A			II
Thickness: 1/4"	Mount Surface: GLASS			